


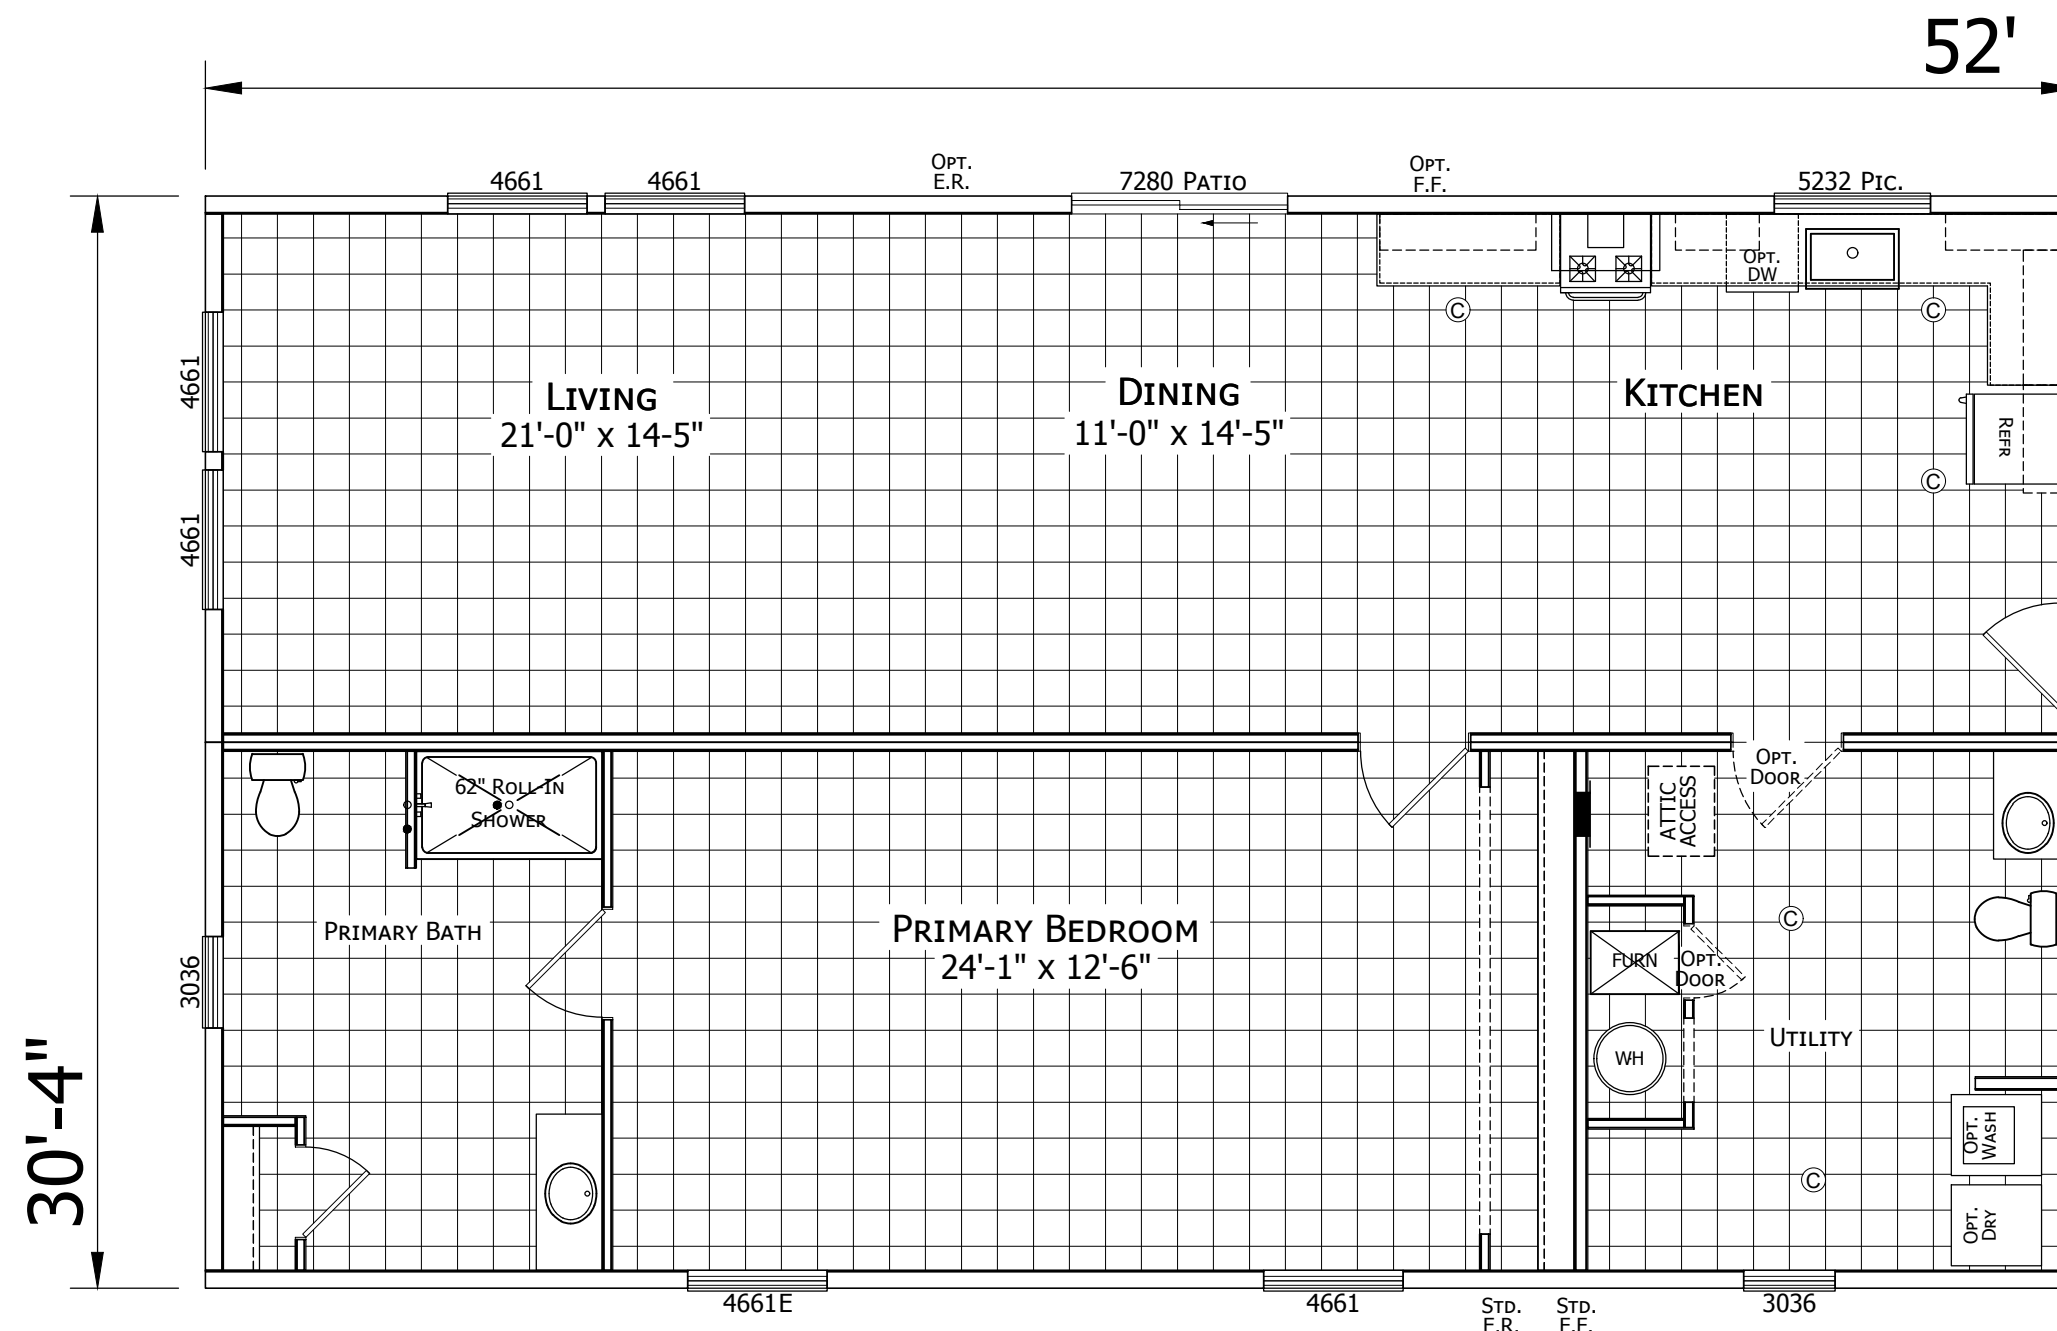

112APB-3252C12ND1
1 BEDROOM 2 BATH
52'-0" x 30'-4"
1577 SQ. FT. TOTAL

SIGN-OFF

RETAILER: _____	DATE: _____
CUSTOMER: _____	DATE: _____

CONTROL # 1001

THIS PRELIMINARY AS-BUILT DRAWING MAY CONTAIN ITEMS NOT TYPICALLY STANDARD IN THIS PRODUCT LINE-PLEASE SEE YOUR HOME'S SPECIFIC ORDER AND SPECIFICATIONS FOR A BREAKDOWN OF WHAT IS STANDARD AND OPTIONAL.

MODIFICATIONS



755 W. BIG BEAVER ROAD, SUITE 1000 TROY, MI 48064
PHONE: 248-614-8200

PROJECT:
112APB-3252C12ND1
52'-0" x 30'-4"
1BD 2BT

DRAWN BY: KG
DATE: 06-04-24
SCALE: 3/16" = 1'-0"

TITLE: **LITERATURE PLAN**

FILENAME: 112APB-3252C12ND1

SHEET: **L-101**

PROPRIETARY AND CONFIDENTIAL
THESE DRAWINGS AND SPECIFICATIONS ARE ORIGINAL
PROPRIETARY AND CONFIDENTIAL MATERIALS OF CHAMPION.
COPYRIGHT © 1976-2024 BY CHAMPION