


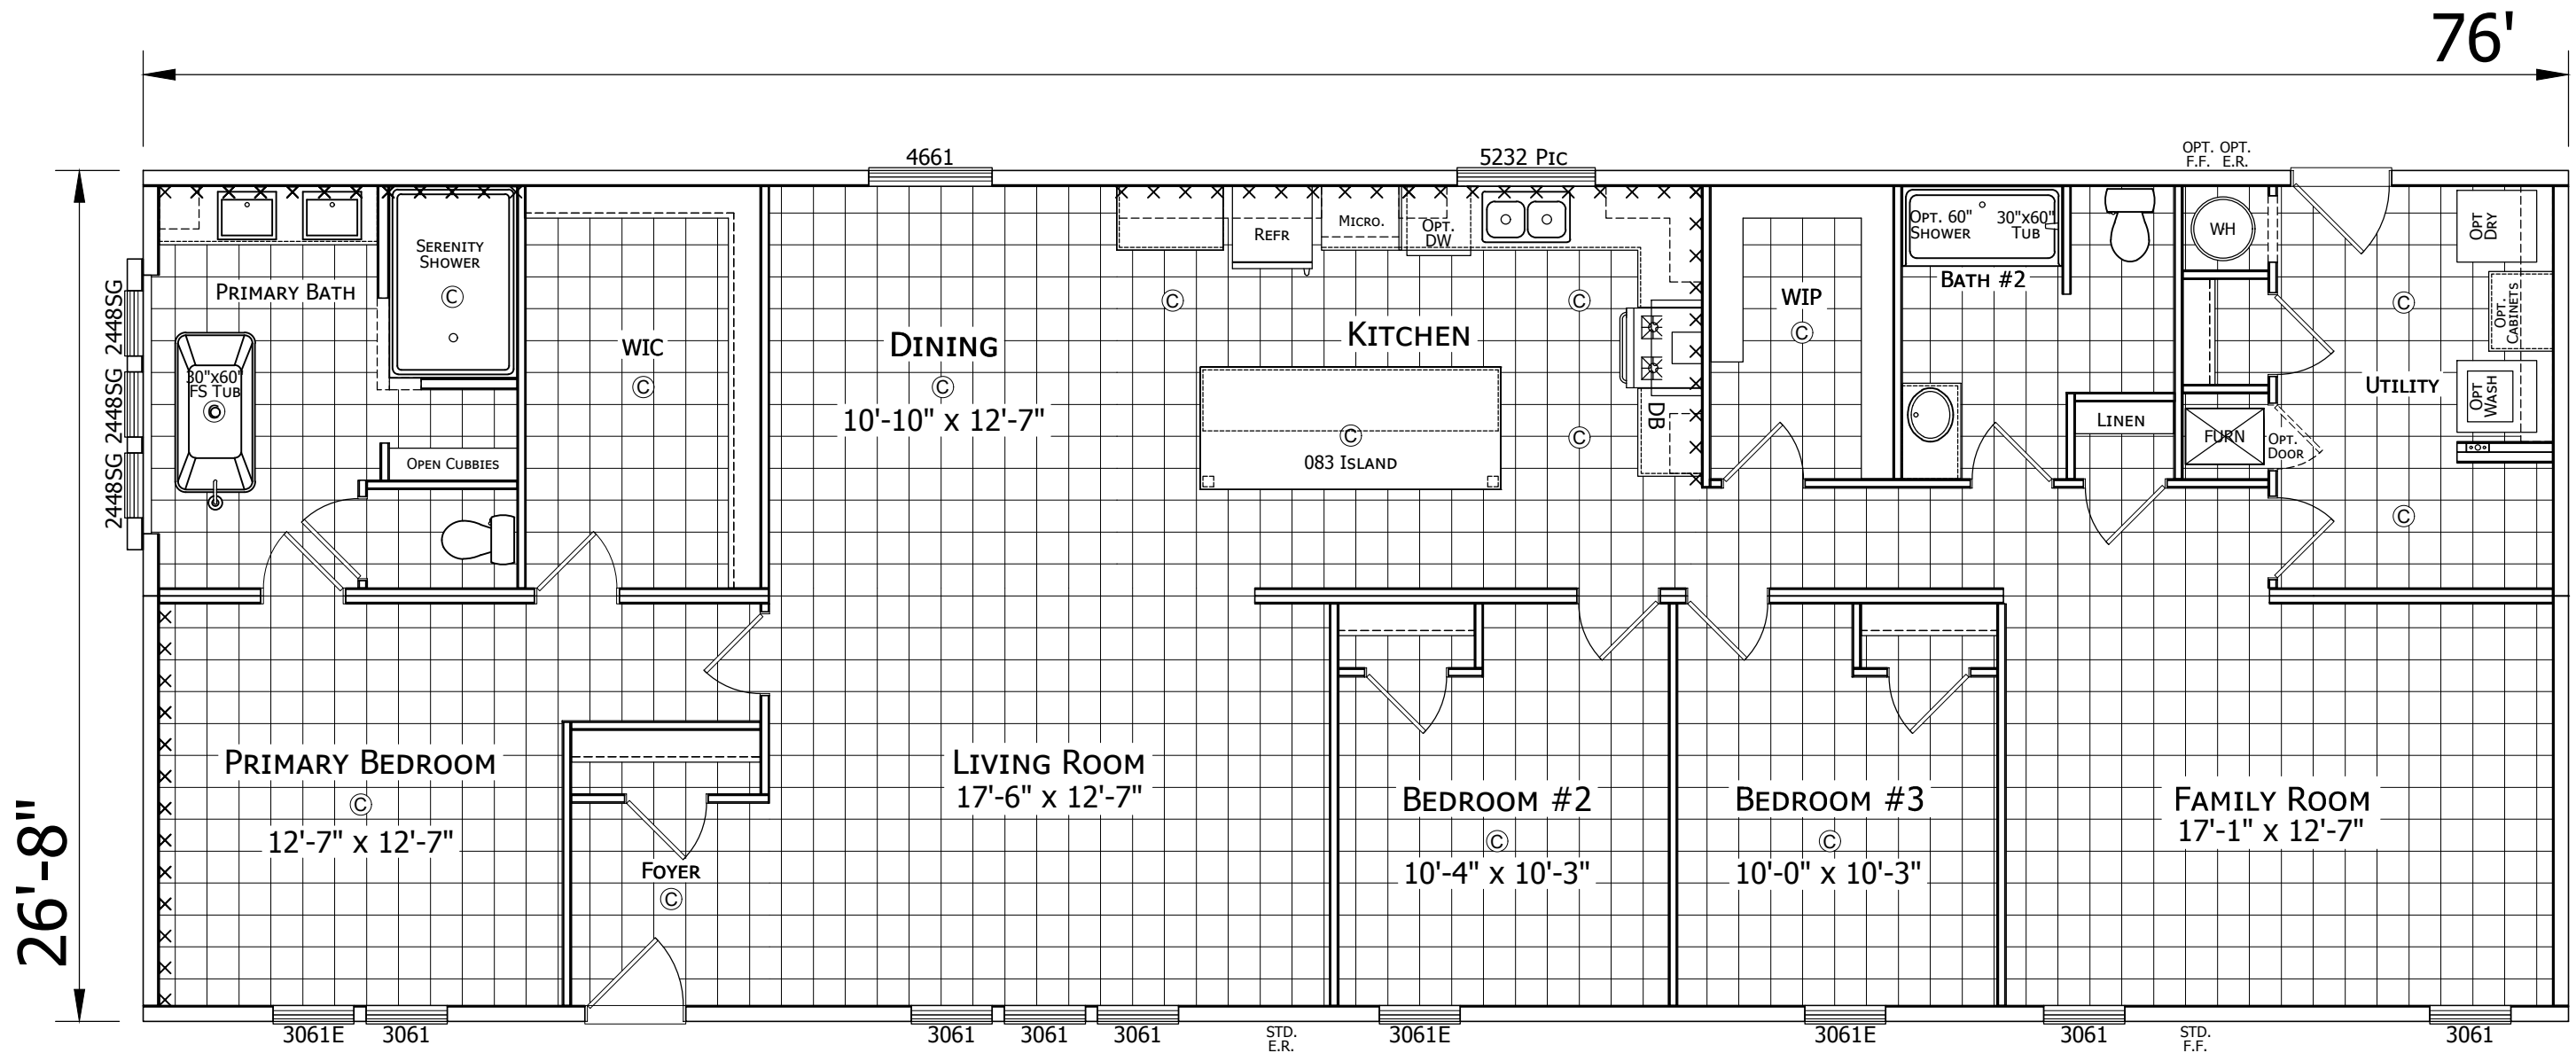

112APB-2868H32394 NH
3 BEDROOM 2 BATH
76'-0" x 26'-8"
2027 Sq. Ft. TOTAL

SIGN-OFF

RETAILER: _____ DATE: _____

CUSTOMER: _____ DATE: _____

CONTROL # 1001

THIS PRELIMINARY AS-BUILT DRAWING MAY CONTAIN ITEMS NOT
TYPICALLY STANDARD IN THIS PRODUCT LINE-PLEASE SEE YOUR
HOME'S SPECIFIC ORDER AND SPECIFICATIONS FOR A BREAKDOWN OF
WHAT IS STANDARD AND OPTIONAL.

MODIFICATIONS

CHAMPION

MANUFACTURED BEAUTIFULLY™

308 SHERIDAN DRIVE TOPEKA, IN 46571

PROJECT:
112APB-2868H32394 NH
68'-0" x 26'-8"
3BD 2BT

DRAWN BY: KG
DATE: 04-07-24
SCALE: 3/16" = 1'-0"

TITLE:
LITERATURE
PLAN

FILENAME: 112APB-2868H32394 NH
WAS 2860 257

SHEET:
L-101

PROPRIETARY AND CONFIDENTIAL
THESE DRAWINGS AND SPECIFICATIONS ARE ORIGINAL
PROPRIETARY AND CONFIDENTIAL MATERIALS OF CHAMPION.
COPYRIGHT © 1976-2024 BY CHAMPION